



**Trade Contractor
Change Order**

Trade Contractor Change Order Number TC-01

LeChase Job Number 1689703
 Trade Contract Number TC-001 Theatrical Systems
 Date of Trade Contract May 20, 2015
 Category Contingency

Building Name: Homer High School
 SED Project Number: 11-07-01-06-0-002-010

Construction Manager: LeChase Construction
Trade Contractor: Sensory Technologies, LLC
Project: Homer CSD - Capital Improvements

Pursuant to and subject to the terms and conditions of the above referenced Trade Contract, Trade Contractor is directed to make the following changes in the Work:

CE#	Scope Change #	Item Description	Budget Code	Approved Amount
225-1		Gymnasium Projector & Lift (Alternate #18)		\$ 68,175.00
TOTAL THIS CHANGE ORDER: TWENTY THOUSAND ONE HUNDRED FIFTY-SEVEN AND XX / 100				\$ 68,175.00

Building Name: Homer High School / SED Project #11-07-01-06-0-002-010
 Change Event 225- HS - TC - Gymnasium Projector & Lift (Alt. #18 (TC))

Except as specifically set forth hereinabove, Trade Contractor waives any and all other claims it may have arising out of or related to the above referenced changes to the Trade Contract. Retention of this Change Order for ten (10) days or commencement of the Work or shipment of materials set forth herein shall constitute acceptance of this Change Order.

Date: August 08, 2016

Original Trade Contract:	\$ 708,465.00
Previous Change Orders:	\$ 0.00
Value This Change Order:	\$ 68,175.00
Revised Trade Contract Amount:	\$ 776,640.00

ACCEPTED -- The above prices and specifications of this Change Order are satisfactory and are hereby accepted. All work to be performed under same terms and conditions as specified in original contract unless before or herein modified.

TRADE CONTRACTOR	ARCHITECT	CONSTRUCTION MANAGER	OWNER
Sensory Technologies, LLC 6951 Corporate Circle Indianapolis, IN 46278	Hunt Engineers, Architects & Lands Airport Corporate Park 100 Hunt Center Horseheads, NY 14845	LeChase Construction 609 Eirie Blvd. West Syracuse, NY 13204	Homer Central School District Administration & Support Offices P.O. Box 500 80 South West Road Homer, NY 13077
Signature: _____ Name: <u>Mickey Ames</u> Title: <u>Project Manager</u> Date: _____	Signature: _____ Name: <u>Reuben Kabithe</u> Title: <u>Project Manager</u> Date: _____	Signature: _____ Name: <u>Lee Stepp</u> Title: <u>Project Manager</u> Date: _____	Signature: _____ Name: <u>Nancy Ruscio</u> Title: <u>Superintendent</u> Date: _____

**Trade Contractor execute and return all originals to Construction Manager -
 Construction Manager execute and mail one original to Trade Contractor**



Change Events

Homer CSD - Capital Improvements **Project #: 1689703**
 Homer High School
 80 S West Road
 Homer, NY 13077

CE#: 225 **Date: 9/22/16**
Category **Reason**
 Contingency Original Project Scope

Reference
 Alternate #18 (TC) / CA-
 A69 / CA-A69A

Open RFQ Number **Change Order Issued**

Description: TC - HS - Area B - Gymnasium Projector & Lift - Alternate #18 - TC

Notes
 Please provide a detailed cost estimate to provide the work of Alternate #18 (TC) - HS - Area B - Gymnasium Projector & Lift.

Summary: Prime Contractor: Sensory Technologies, LLC Theatrical Svstems Contract

General Description	Quote Due Date	Quote Rec'd	Proposed	Approved	Applied
Gymnasium Projector & Lift	9/28/2016	9/22/2016	\$68,175.00	\$68,175.00	\$68,175.00



150 Metro Park
 Rochester, NY 14623
 317-347-5252

**** Proposal ****

9/22/2016

Project Number: 50414ALT-18

For :
Homer Central School District Gym AV System Alt T-1-18 Customer P.O.: AIA CONTRACT 2503-014

** Proposal ** to:
Homer Central School District 80 South West Road Homer, NY 13077
Tel: 607-749-7241

Project Site:
Homer Central School District 80 South West Road Homer, NY 13077

Mfr-Part No.	Qty	Description	Unit Price	Extended
		CHANGE ORDER - ALT18 ADD		
AJA-HI5	2	HD-SDI/SDI to HDMI Video and Audio Converter		
	1	Custom Part - Front Wire Guard		
CHRISTIE-140-009100-01	1	D12WU-H Black		
	1	Christie Lens Full ILS 2.0-4.0:1		
Crestron-CEN-GWEXE R-PWE	1	infiNET EX« & ER Wireless Gateway w/PoE Injector		
Crestron-DMPS3-4K-15 0-C	1	3-Series 4K DigitalMediao Presentation System 150		
Crestron-DM-RMC-4K-S CALER-C	1	4K DigitalMedia 8G+ Receiver & Room Controller		
		w/Scaler		
Crestron-DM-TX-200-C-2G-B-T	1	Wall Plate DigitalMedia 8G+ Transmitter 200,		
		Black Textured; includes PW-2407WUL		
Crestron-DM-TX-201-C	1	DigitalMedia 8G+ Transmitter 201		
Crestron-GLA-PWS50	1	Wall Mount 50 Watt Cresnet Power Supply		
Crestron-TST-602-WAL L-B-T	1	5.7 Wall Mount Wireless Touch Screen, Black		
		Textured		
Middle Atlantic-RSH4A5S	1	CUS RACKSHLF5SP ANOD 11.5		
		^^ RSH4A5S CRESTRON TST600DSWBT		
	1	Da-Lite - 35270CL, QTE#20219722 9/21/16		
		^^Quote is in project folder		
Extron-26-663-06	1	HDMI Ultra 6 (1.8 m)		
B&H-52030	1	DB9-F, 6' cable		
Middle Atlantic-D4LK	1	4 SPACE (7#) RACK DRAWER, BLACK BRUSHED FINISH, WITH KEYLOCK WITH KEYLOCK		
Middle Atlantic-DWR-35-22	1	35 SPACE (61 1/4#) SECTIONAL WALL RACK, FITS 20# DEEP EQUIP., BL DEEP EQUIP., BLACK FINISH		

Mfr-Part No.	Qty	Description	Unit Price	Extended
Netgear-GS108PE-300 NAS	1	ProSAFE 8-port Gigabit Plus Switch		
Middle Atlantic-UFA-8-F1	1	1 SPACE UNIVERSAL FACE AFTER SHELF, 8 DEEP WITH 1 SPACE FLANGED		
	1	Proco - PCEI-100		
	1	Ralph Schwartz - Lift LOT		
	1	Ralph Schwartz - Proj LOT		
	1	SVS - Cable Retractor		
	1	SVS - 7EX-22		
	1	SVS - Accessory #2 - Lift Ceiling Closure		
	1	SVS - Accessory #9 - Lift Projector Mount		
	2	Whirlwind - Custom Plate CC		
	1	Whirlwind - Custom Plate DMA		
	1	Whirlwind - Custom Plate DMP		
	1	IP - Installation Parts		
		SUBTOTAL - ALT 18		67,078.94
		TOTAL		67,078.94
		Installation Includes:		
		- Engineering & Design Services		
		- Project Management Services		
		- In-Shop Fabrication		
		- System Installation Labor		
		- Programming & Software Development		
		- User Training		
		- Travel Expenses		

This ** Proposal ** is Valid for 60 Days.
Freight: 1096.06

Signature: _____ Date: _____

Shipping & Handling:	\$1,096.06
Project Total:	<u>\$68,175.00</u>


DRAWN BY:
 ACA
 CHECKED BY:
 RMK
 DATE:
 9/12/16
 SCALE:
 1/8" = 1'-0"
 REVISION:

Unauthorized Alteration Or Addition To Plans Bearing A Licensed Engineer's or Architect's Seal, Is A Violation of Section 7209 Of The New York State Education Law.
 Copyright © 2016


HUNT
 ENGINEERS/ARCHITECTS/SURVEYORS
 AIRPORT CORPORATE PARK
 100 HUNT CENTER
 HORSEHEADS, N.Y. 14845
 607 • 356 • 1000
 FAX • 356 • 1800
 ROCHESTER, NY
 TOWANDA, PA
 HORSEHEADS, NY

GYMNASIUM SCREEN LOCATION
 HOMER CENTRAL SCHOOL DISTRICT
 CAPITAL IMPROVEMENTS PROJECT
 HOMER, N.Y.


CA-A69
 PROJECT NO:
 2503-014

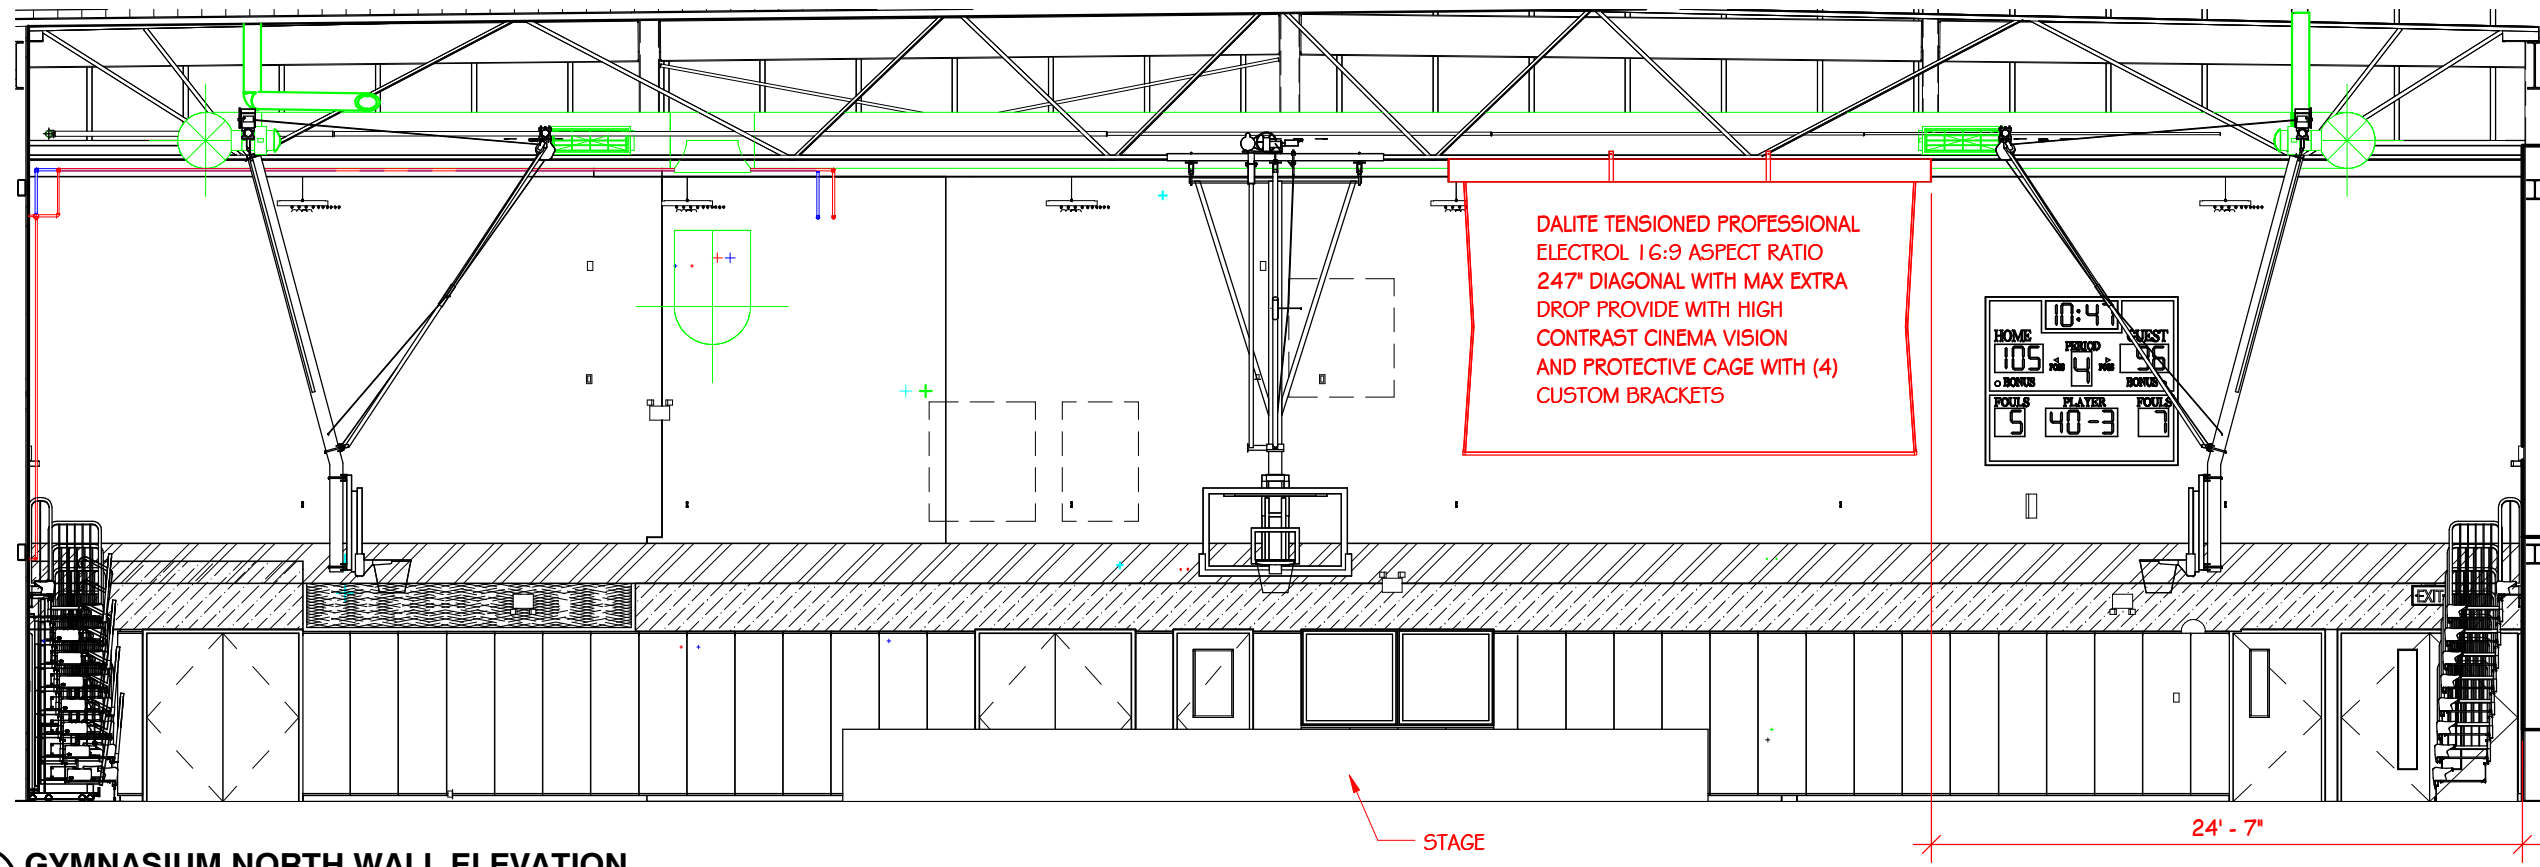

DALITE TENSIONED PROFESSIONAL
 ELECTROL 16:9 ASPECT RATIO
 247" DIAGONAL WITH MAX EXTRA
 DROP PROVIDE WITH HIGH
 CONTRAST CINEMA VISION
 AND PROTECTIVE CAGE WITH (4)
 CUSTOM BRACKETS

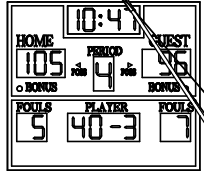

1 GYMNASIUM NORTH WALL ELEVATION
 1/8" = 1'-0"

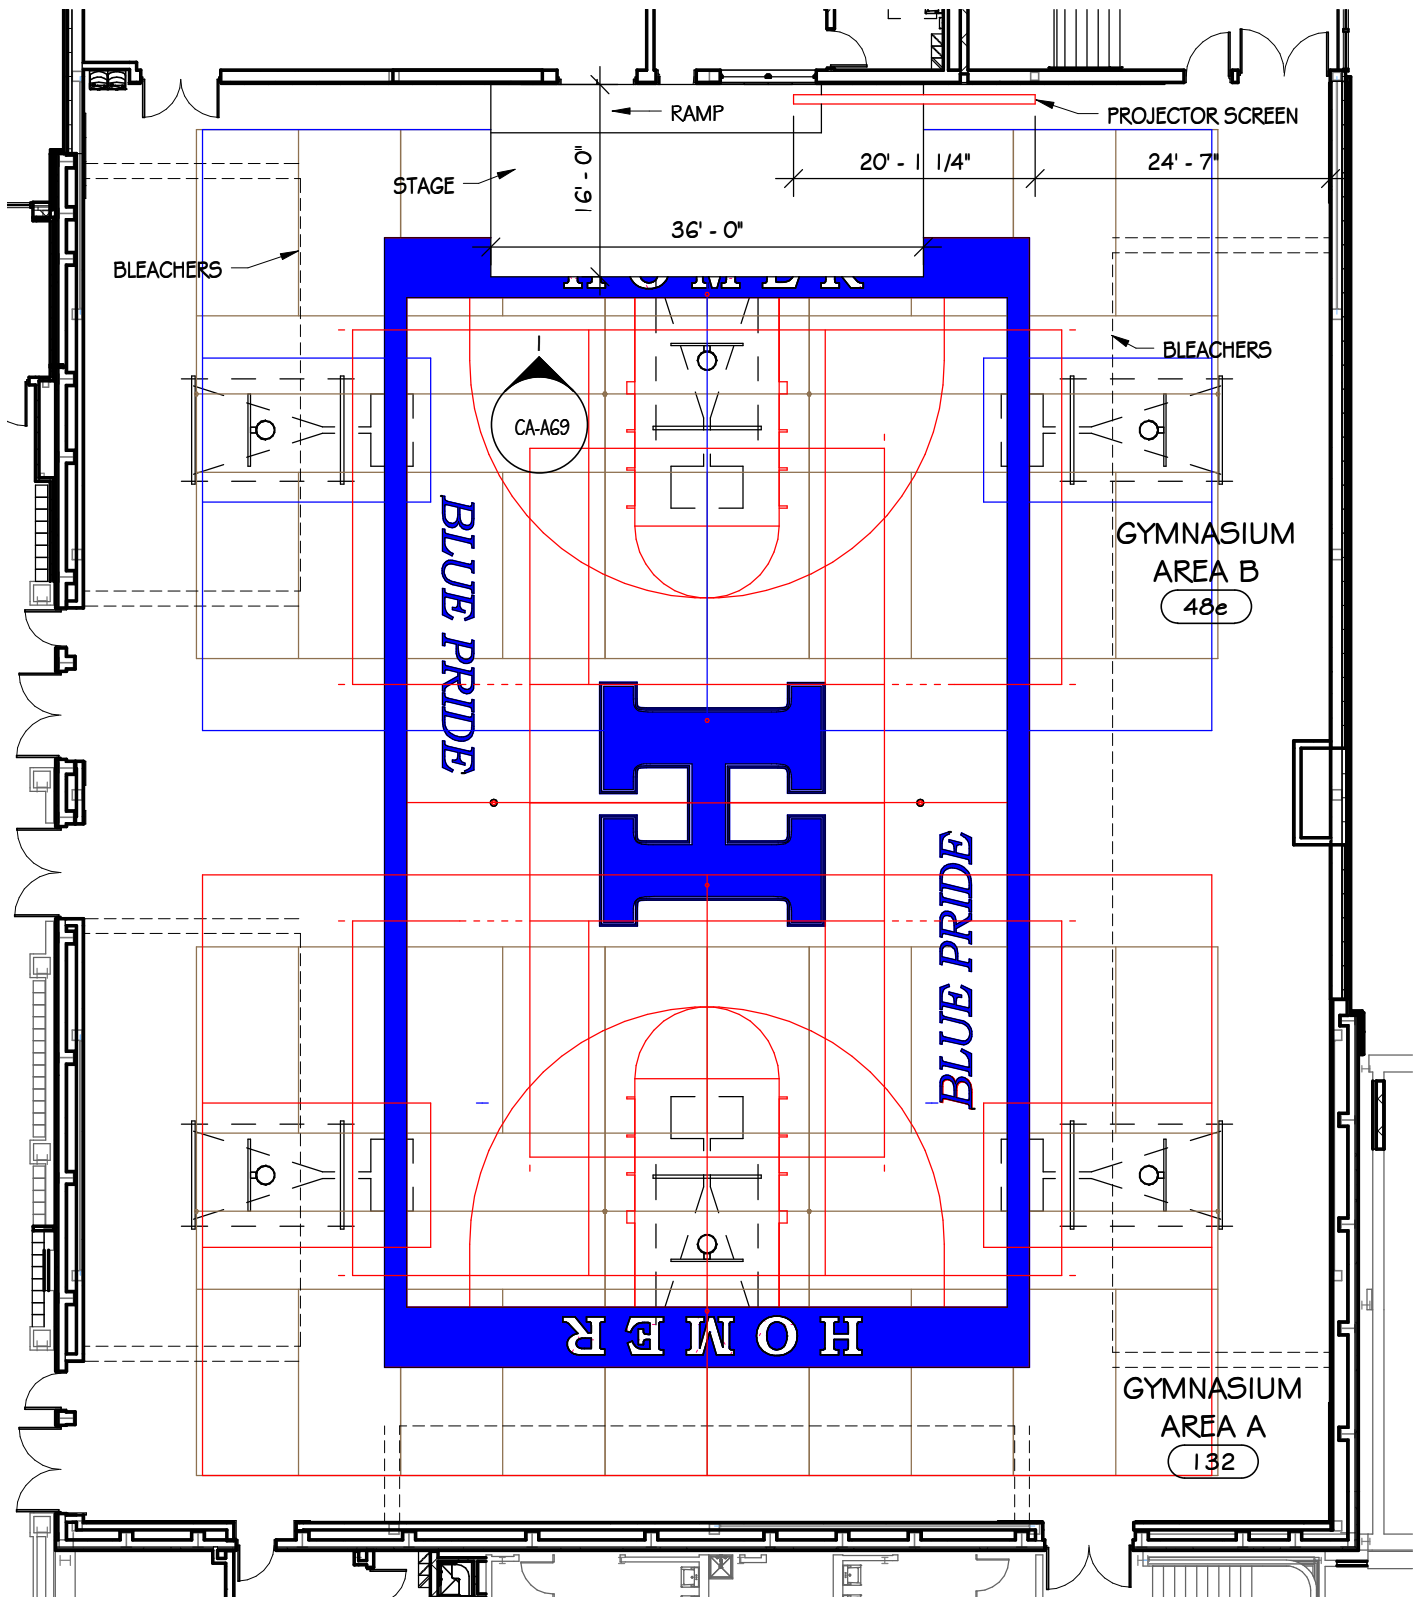

1 GYMNASIUM LINEWORK AND OPEN BLEACHER WITH STAGE PLAN
 1/16" = 1'-0"

GYMNASIUM PROJECTOR LOCATION
HOMER CENTRAL SCHOOL DISTRICT
CAPITAL IMPROVEMENTS PROJECT
 HOMER, N.Y.

Copyright: 2016



AIRPORT CORPORATE PARK
 100 HUNT CENTER
 HORSEHEADS, N.Y. 14845
 607 • 358 • 1000
 FAX • 358 • 1800

HORSEHEADS, NY

ROCHESTER, NY

TOWANDA, PA

CA-A69A

DATE:
 09/12/16

PROJECT NO:
 2503-014